AS-BUILT RIVERWOOD AVE SE BEGIN TO 11+20

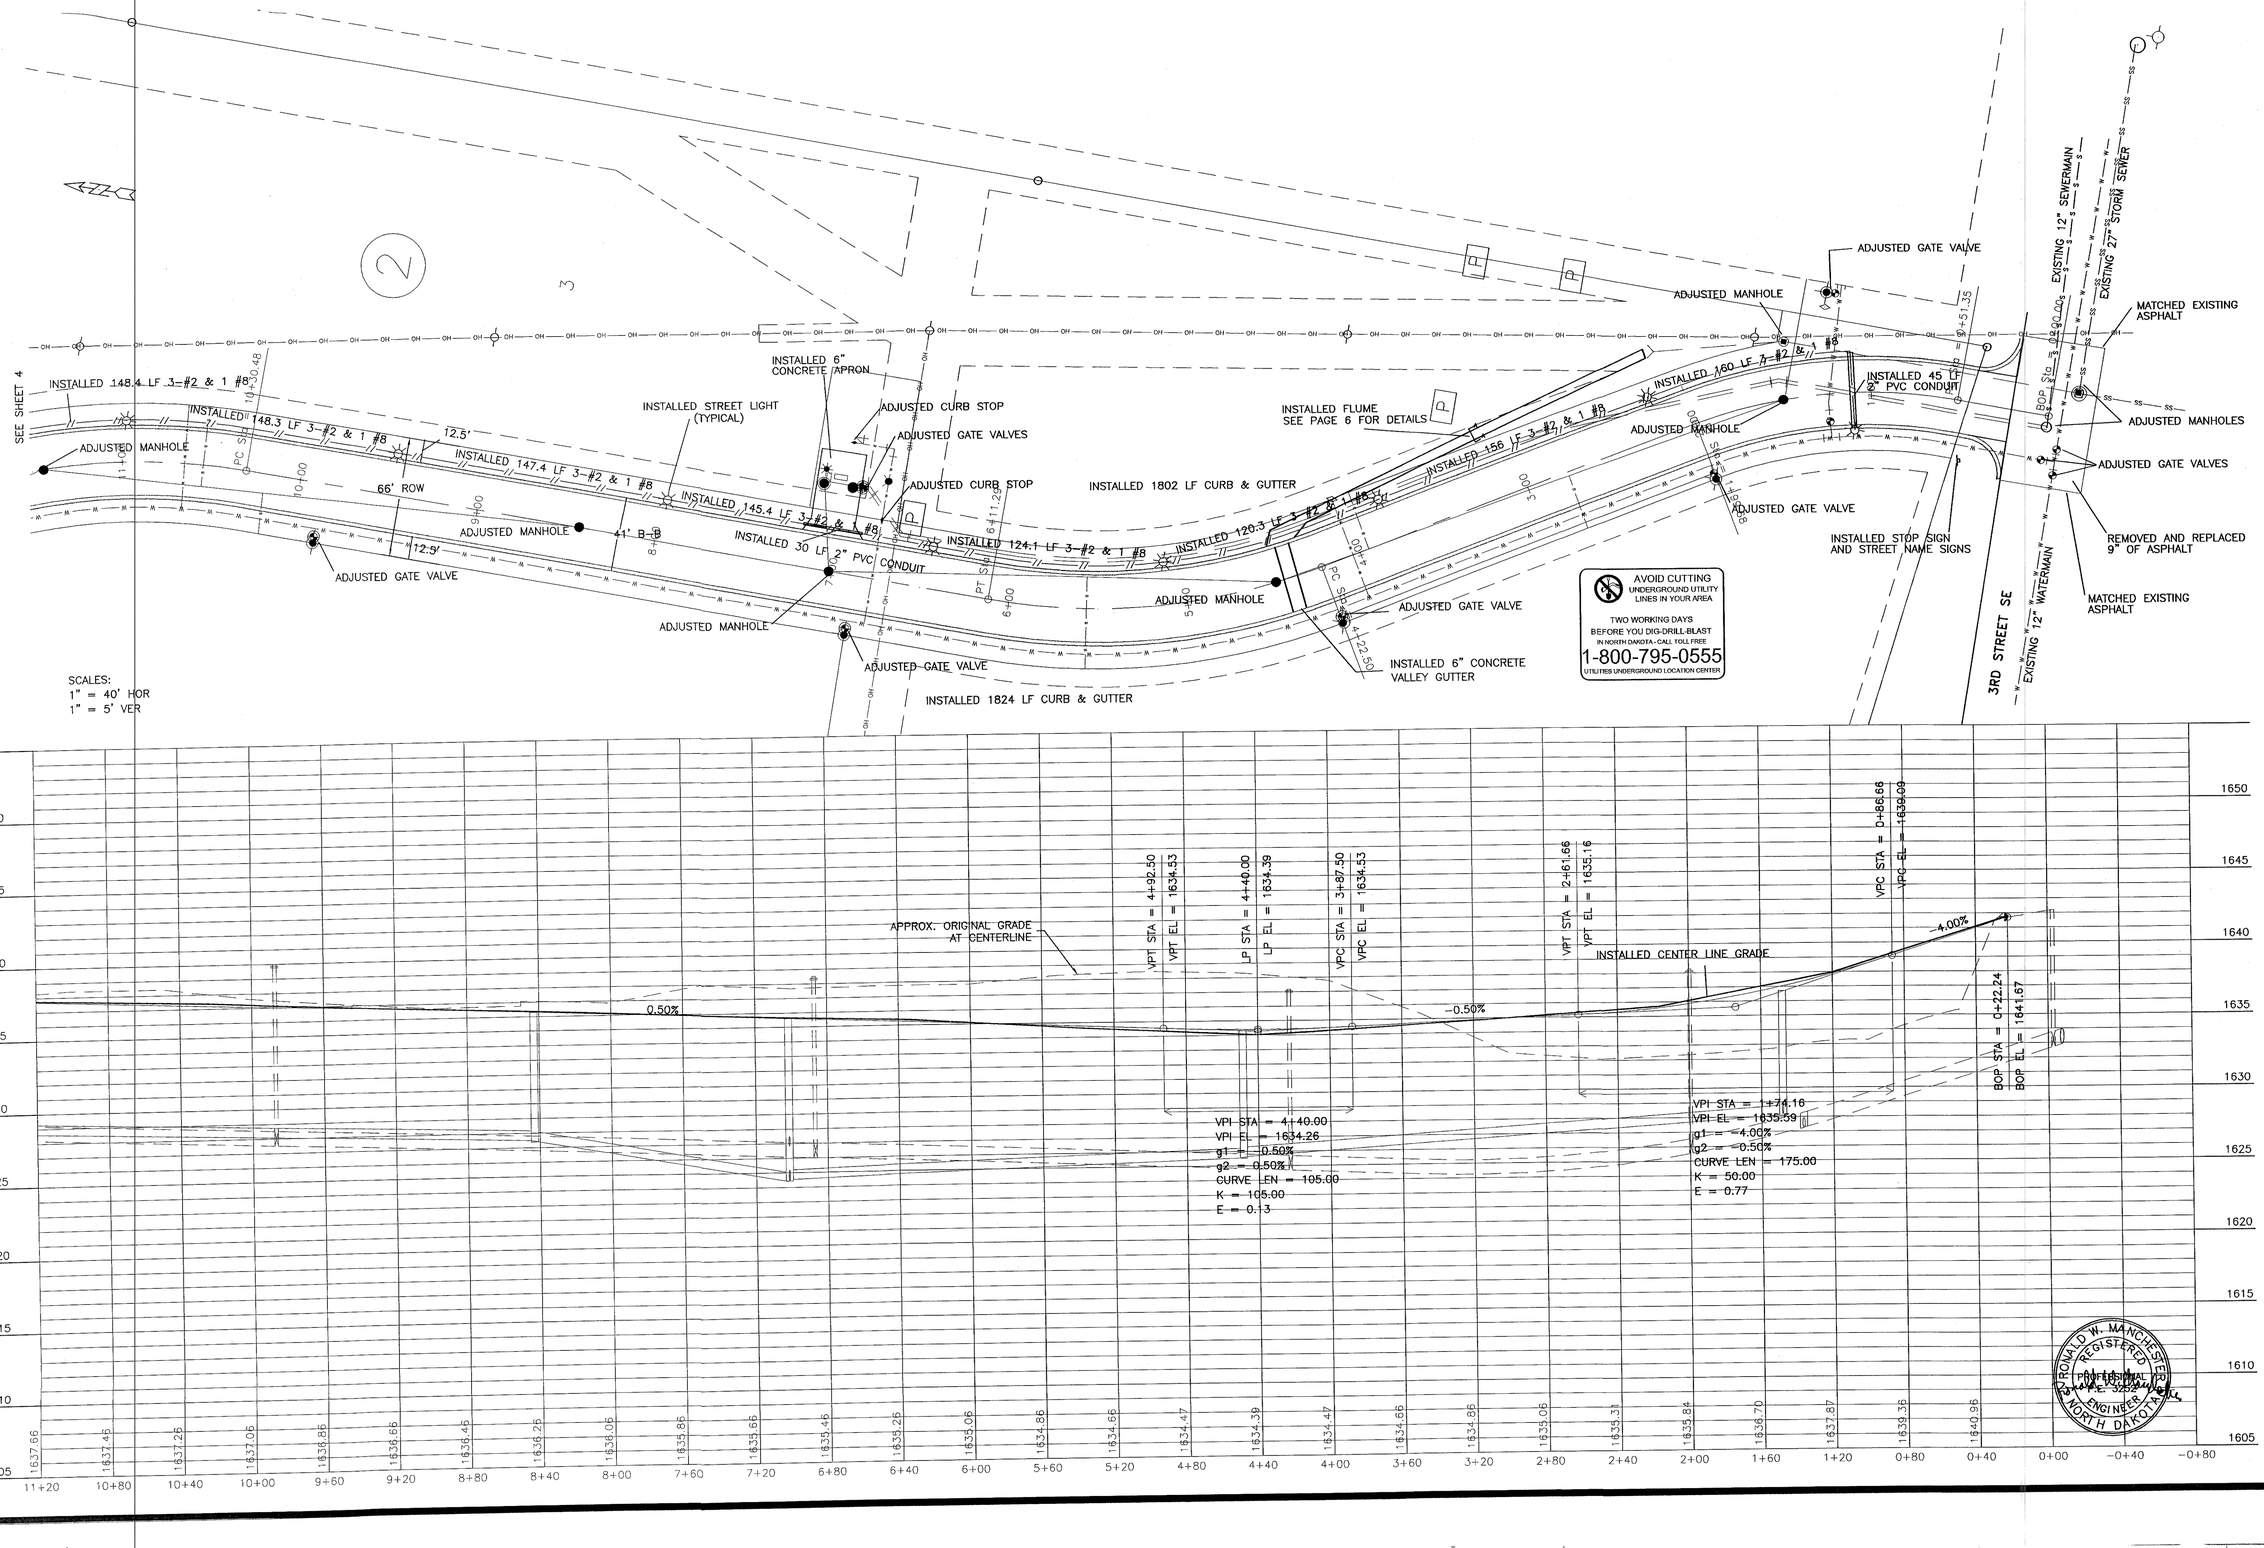

RONALD W. MANCHESTER
REGISTERED
PROFESSIONAL
ENGINEER
NORTH DAKOTA

TOMAN ENGINEERING COMPANY
CONSULTING CIVIL ENGINEERS
906 2ND ST. N.W. • MANDAN, NORTH DAKOTA 58554 • 701-663-6483

PROJECT:
STREET IMPROVEMENT DIST. #124 AREA "B"
RIVERWOOD COMMERCIAL PARK AS-BUILT
RIVERWOOD AVE SE BEGIN TO 11+20

CITY NO. 2004-25	DATE 07/15/04
TEDO NO. 21-45	DATE
DRAWN BY: JAM	DATE
CHECKED BY:	DATE
APPROVED BY:	DATE

TITLE: STREET IMPROVEMENT DISTRICT #124 AREA "B"

NO.	REVISIONS	BY	DATE

SHEET NUMBER
3
OF 7 SHEETS