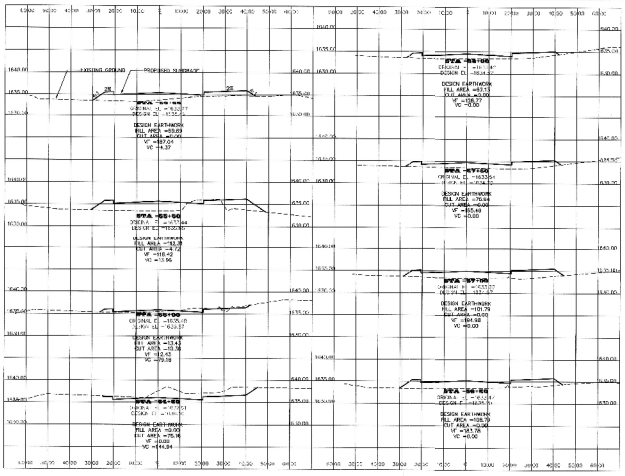

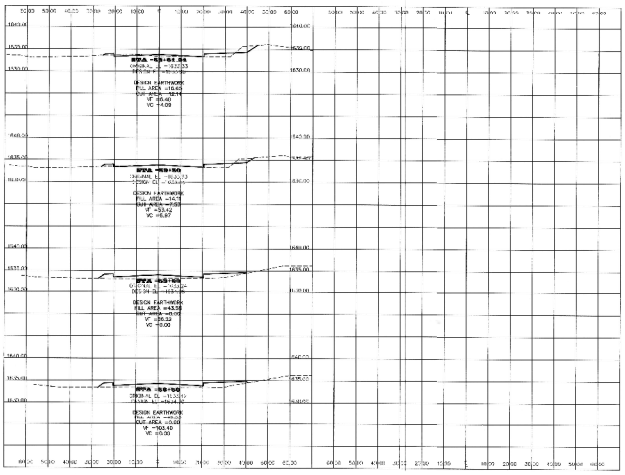

CROSS SECTIONS ON 19TH STREET SE
DISTRICT 133 PROJECT 2005-16

SWENSON, HAGEN & COMPANY P.C.
Architects
Planners
Interior Designers
Landscape Architects
Preservation Consultants
1 Eastbrook Ctr. Ste. 115
Fargo, ND 58103
Phone: (701) 232-3500
Fax: (701) 232-3557

DRAWN BY: WPV
CHECK BY: JRP/GJF
DATE: 05-10-05
FILE DESC:
Disk date
COMPUTER FILE:
SURVEY FILE:

SHEET
C18
OF 19

GREGORY J. FERCHE
REGISTERED
PROFESSIONAL
ENGINEER
NORTH DAKOTA

Record Drawing

P:\Standard Llayouts\Commercial 3rd Party Xs\xs dwg 4/19/2005 11:17:50 TSC_grn.gif