


PLAN
 SURVEYED: _____
 PLOTTED: _____
 NOTE BOOK NO. _____
 DATE _____
 BY _____
 CHECKED: _____
 RT. OF WAY CHECKED: _____



PROFILE
 SURVEYED: _____
 PLOTTED: _____
 NOTE BOOK NO. _____
 DATE _____
 BY _____
 CHECKED: _____
 STRUCTURE NOTATIONS (H/V/D)

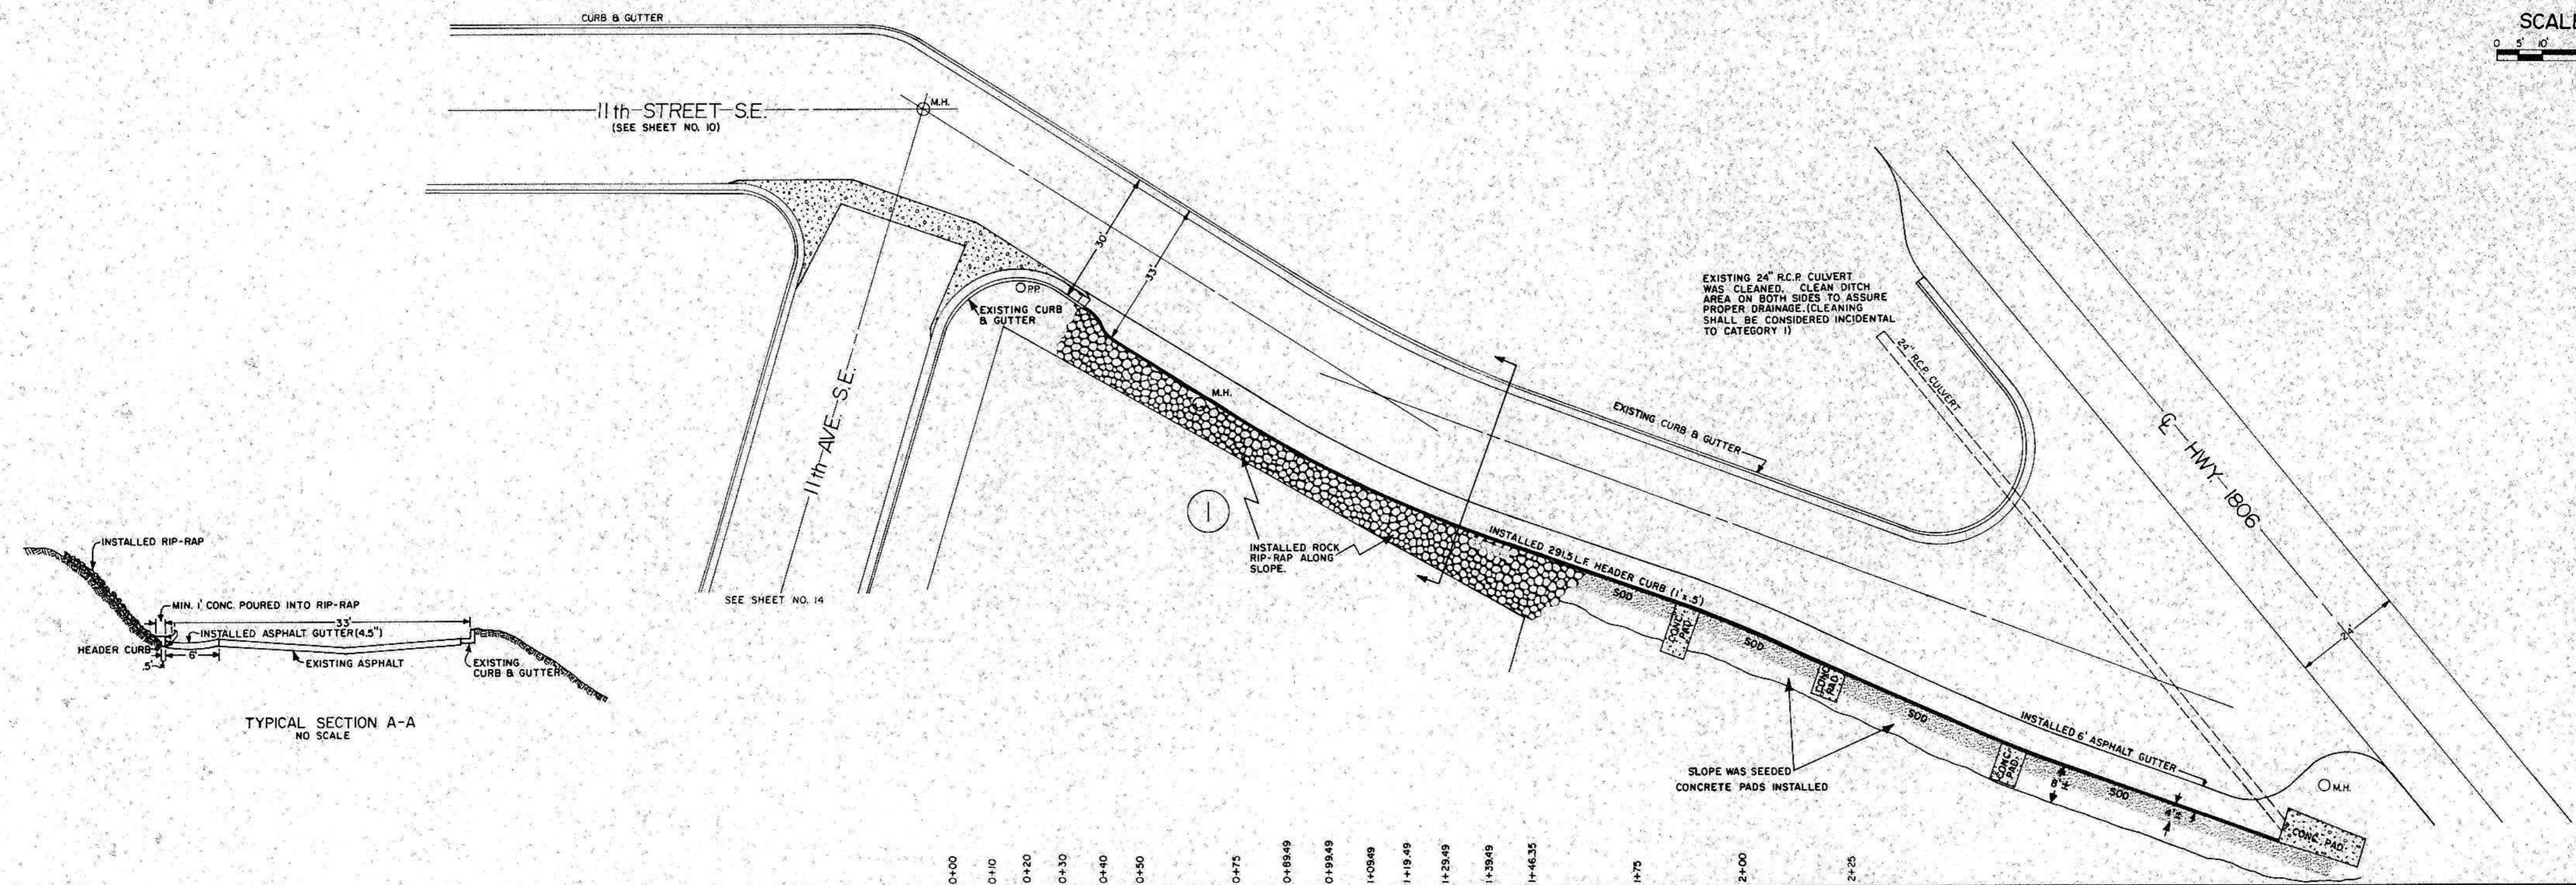