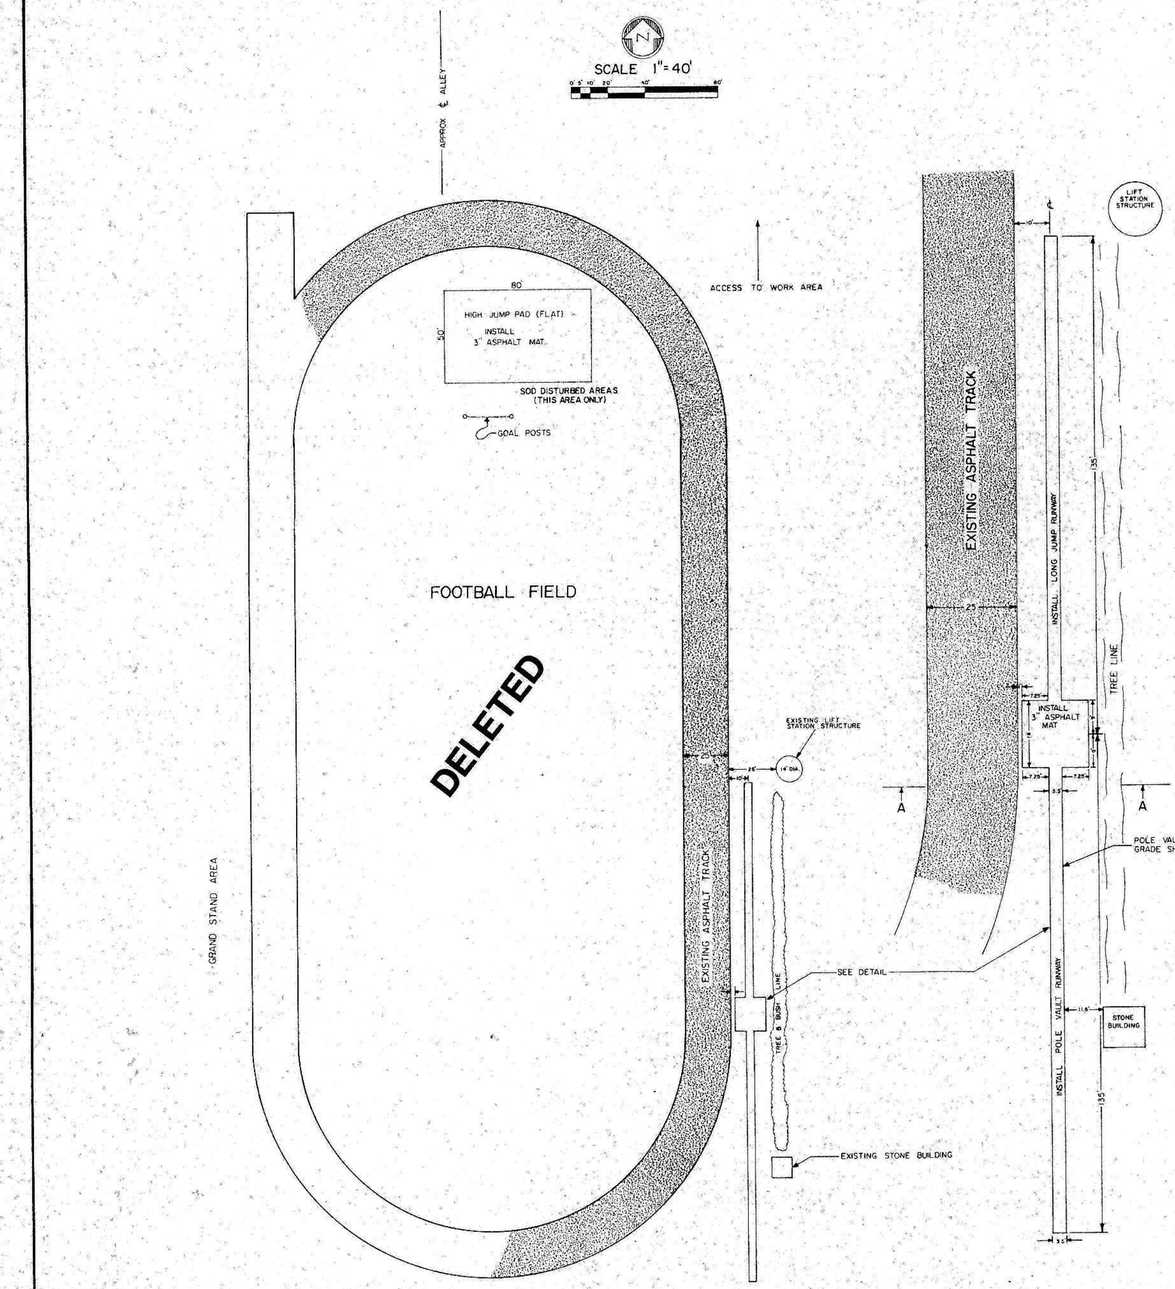

GENERAL LAYOUT

MANDAN ATHLETIC FIELD

DELETED

GENERAL NOTES:

1. Asphalt mats to be 3" thick.
2. All asphalt mats to have a 6" compacted granular base.
3. Areas under asphalt shall have soil sterilizer applied prior to gravel installation.
4. The top 6" of subgrade shall be scarified and recompacted prior to gravel installation.
5. Excess dirt to be moved to waste area.
6. No vehicles will be allowed to drive on the existing track and football field.
7. All areas around the new mats shall be shaped to blend into the existing area.
8. All areas disturbed shall be seeded or sodded as noted.

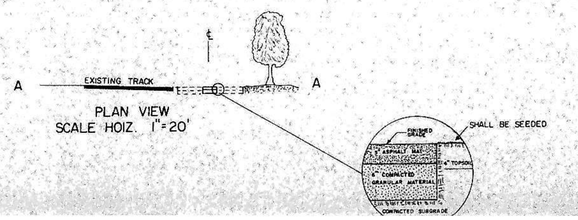

PLAN VIEW
SCALE HOIZ. 1"=20'

SCALE: HORZ 1" = 50'
VERT 1" = 5'

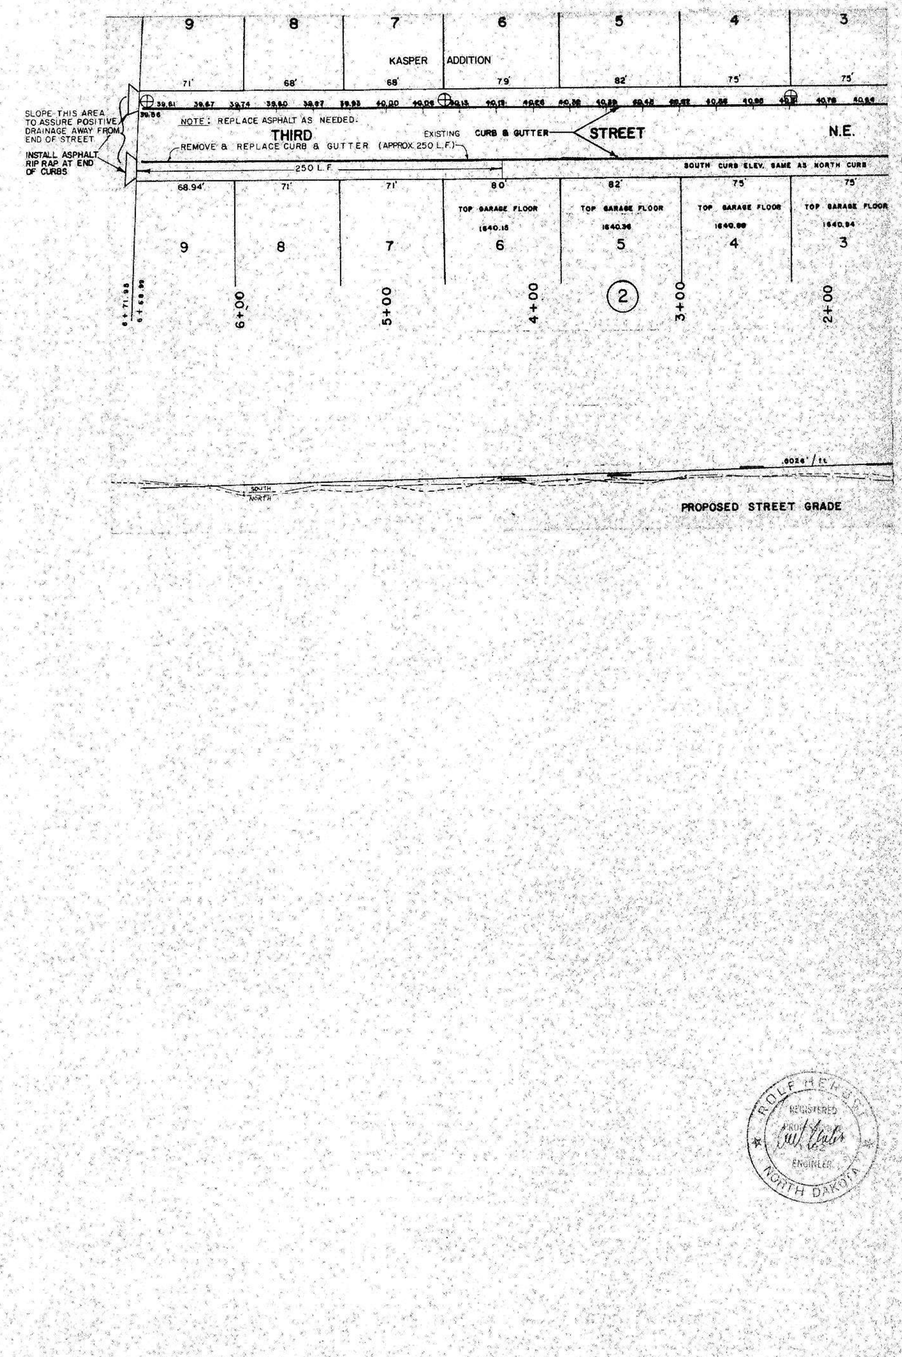

ROLF HEMSOTT
REGISTERED
PROFESSIONAL
ENGINEER
NORTH DAKOTA

STREET IMPROVEMENT DISTRICT NO. 56 MANDAN, N.D.

SHEET NO. 18 OF 23 SHEETS

ASBUILT CONSTRUCTION DRAWINGS