

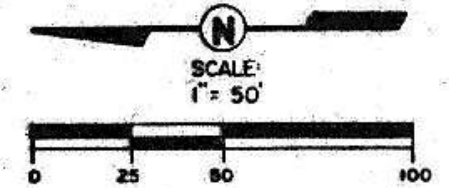
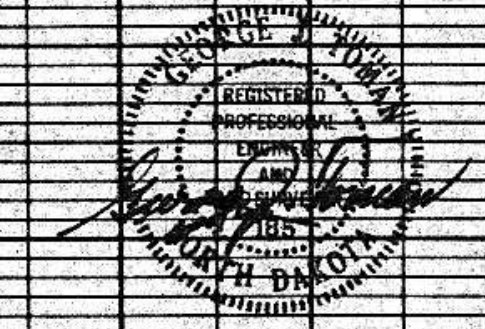


43RD AVE. S.E.

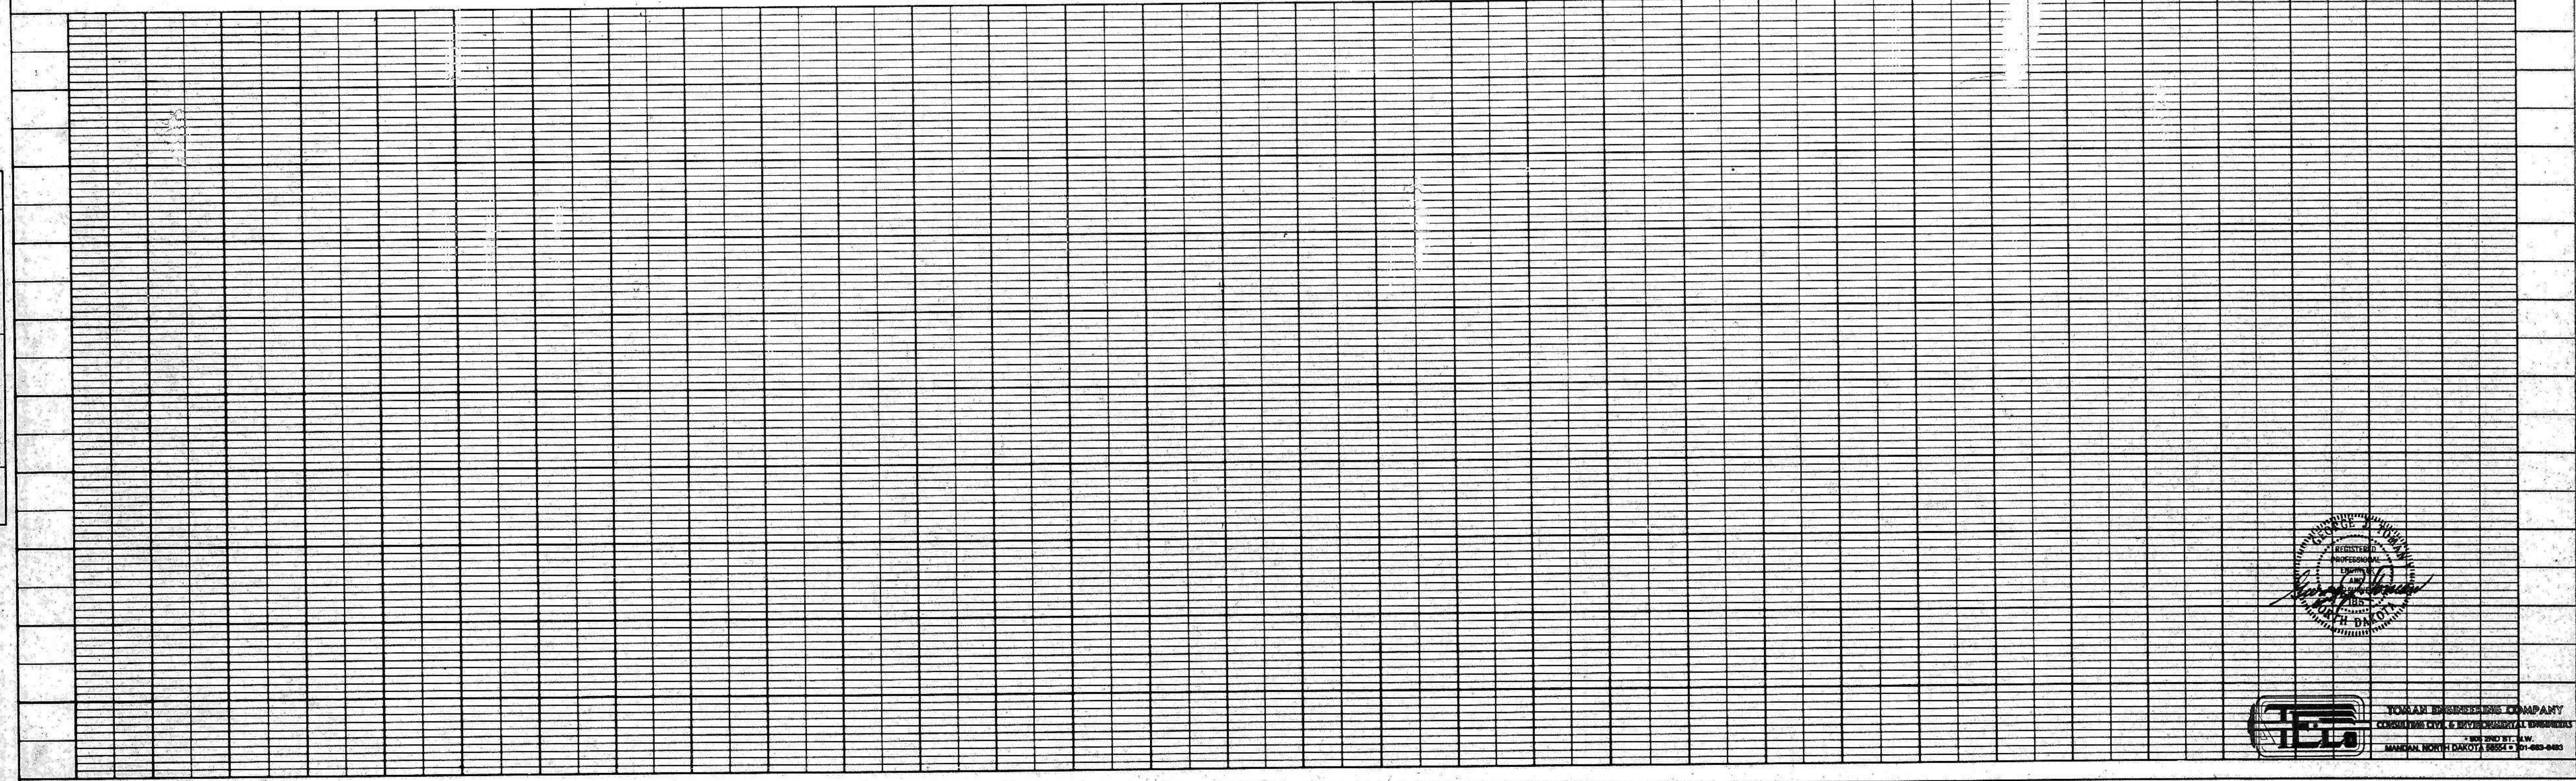

DATE: _____ BY: JRM (1-81)
 PLAN: AS-BUILT CORRECTIONS
 NOTE BOOK: _____
 NO. _____
 PLANNING CHECKED: _____
 P.T. OF DAY CHECKED: _____

DATE: _____ BY: _____
 PROFILE: _____
 NOTE BOOK: _____
 NO. _____
 SURVEY CHECKED: _____
 P.T. OF DAY CHECKED: _____

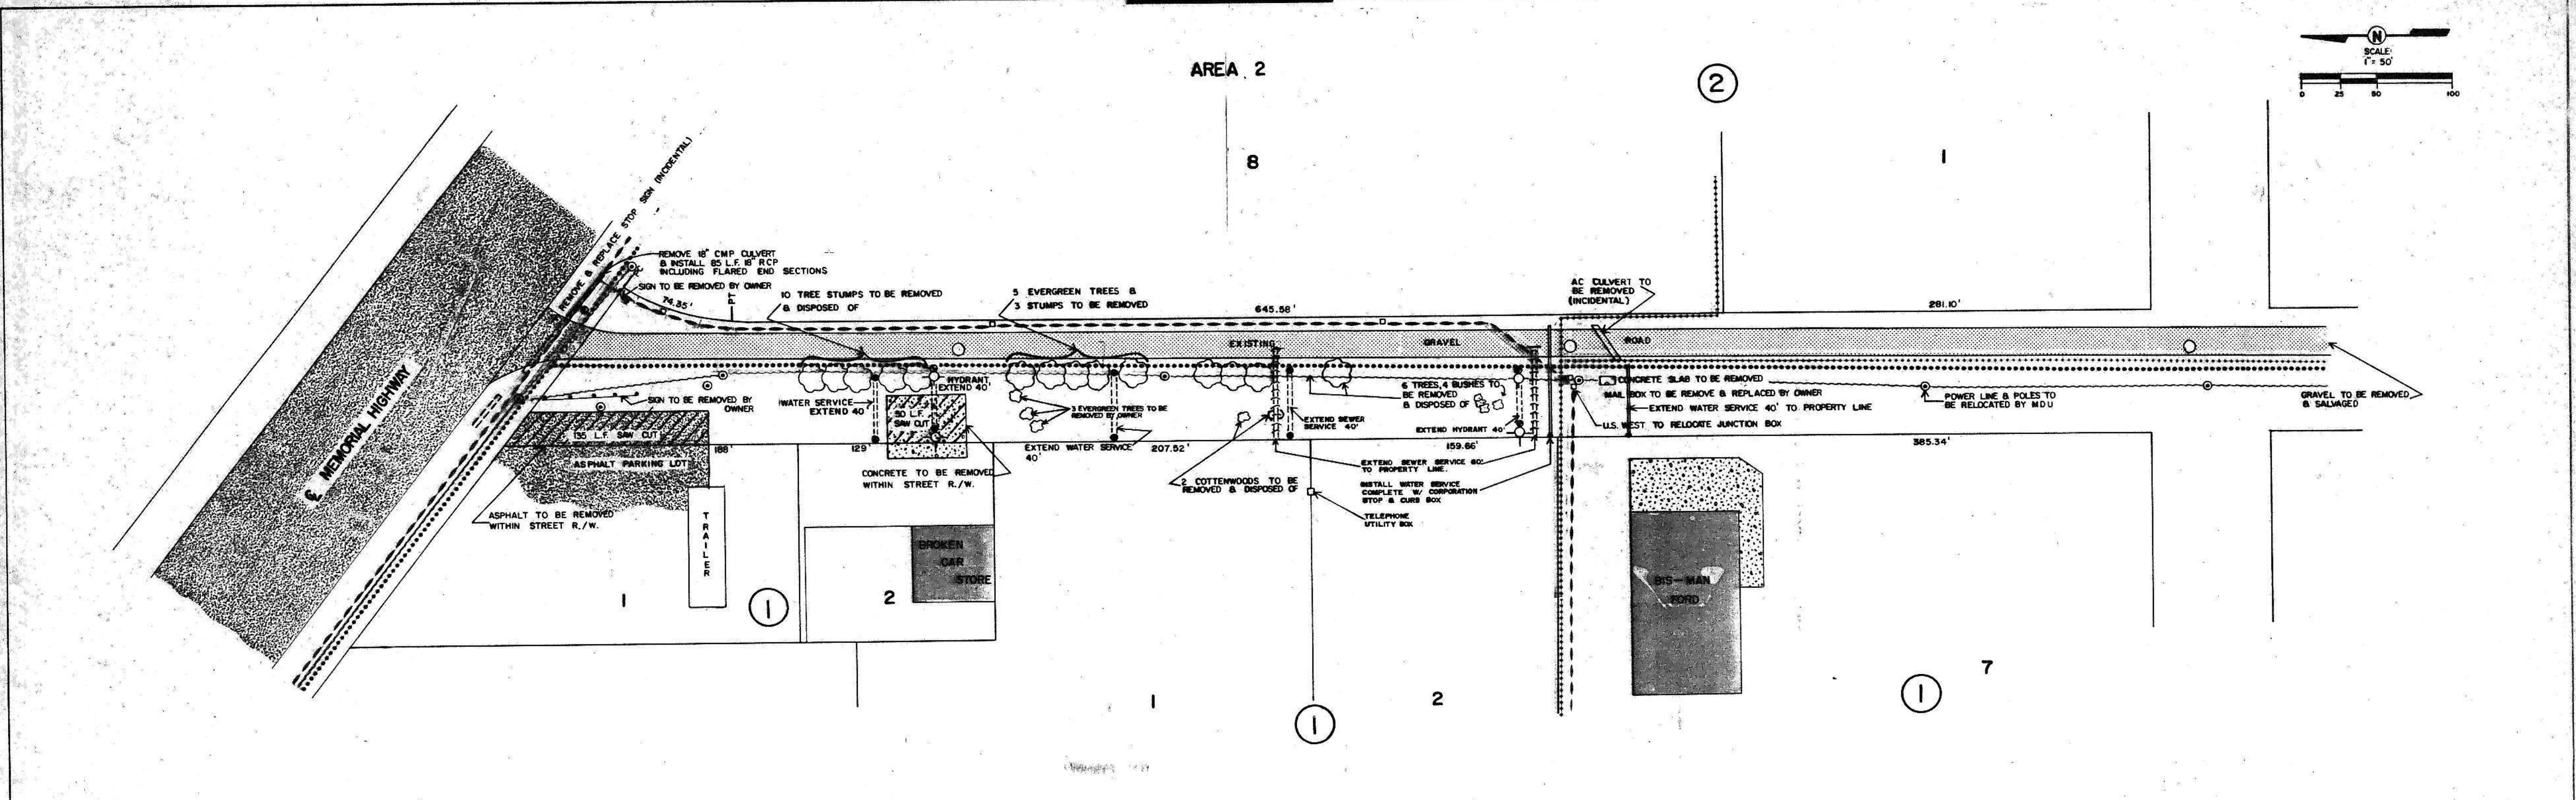

TEC
 TOLAN ENGINEERING COMPANY
