

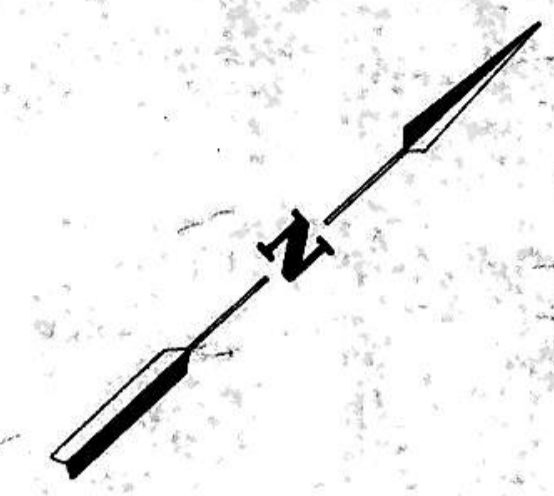


PLAN
 SURVEYED BY: [blank]
 DATE: [blank]
 NOTE BOOK NO.: [blank]
 ALIGNMENT CHECKED BY: [blank]
 ST. OF WAY CHECKED BY: [blank]

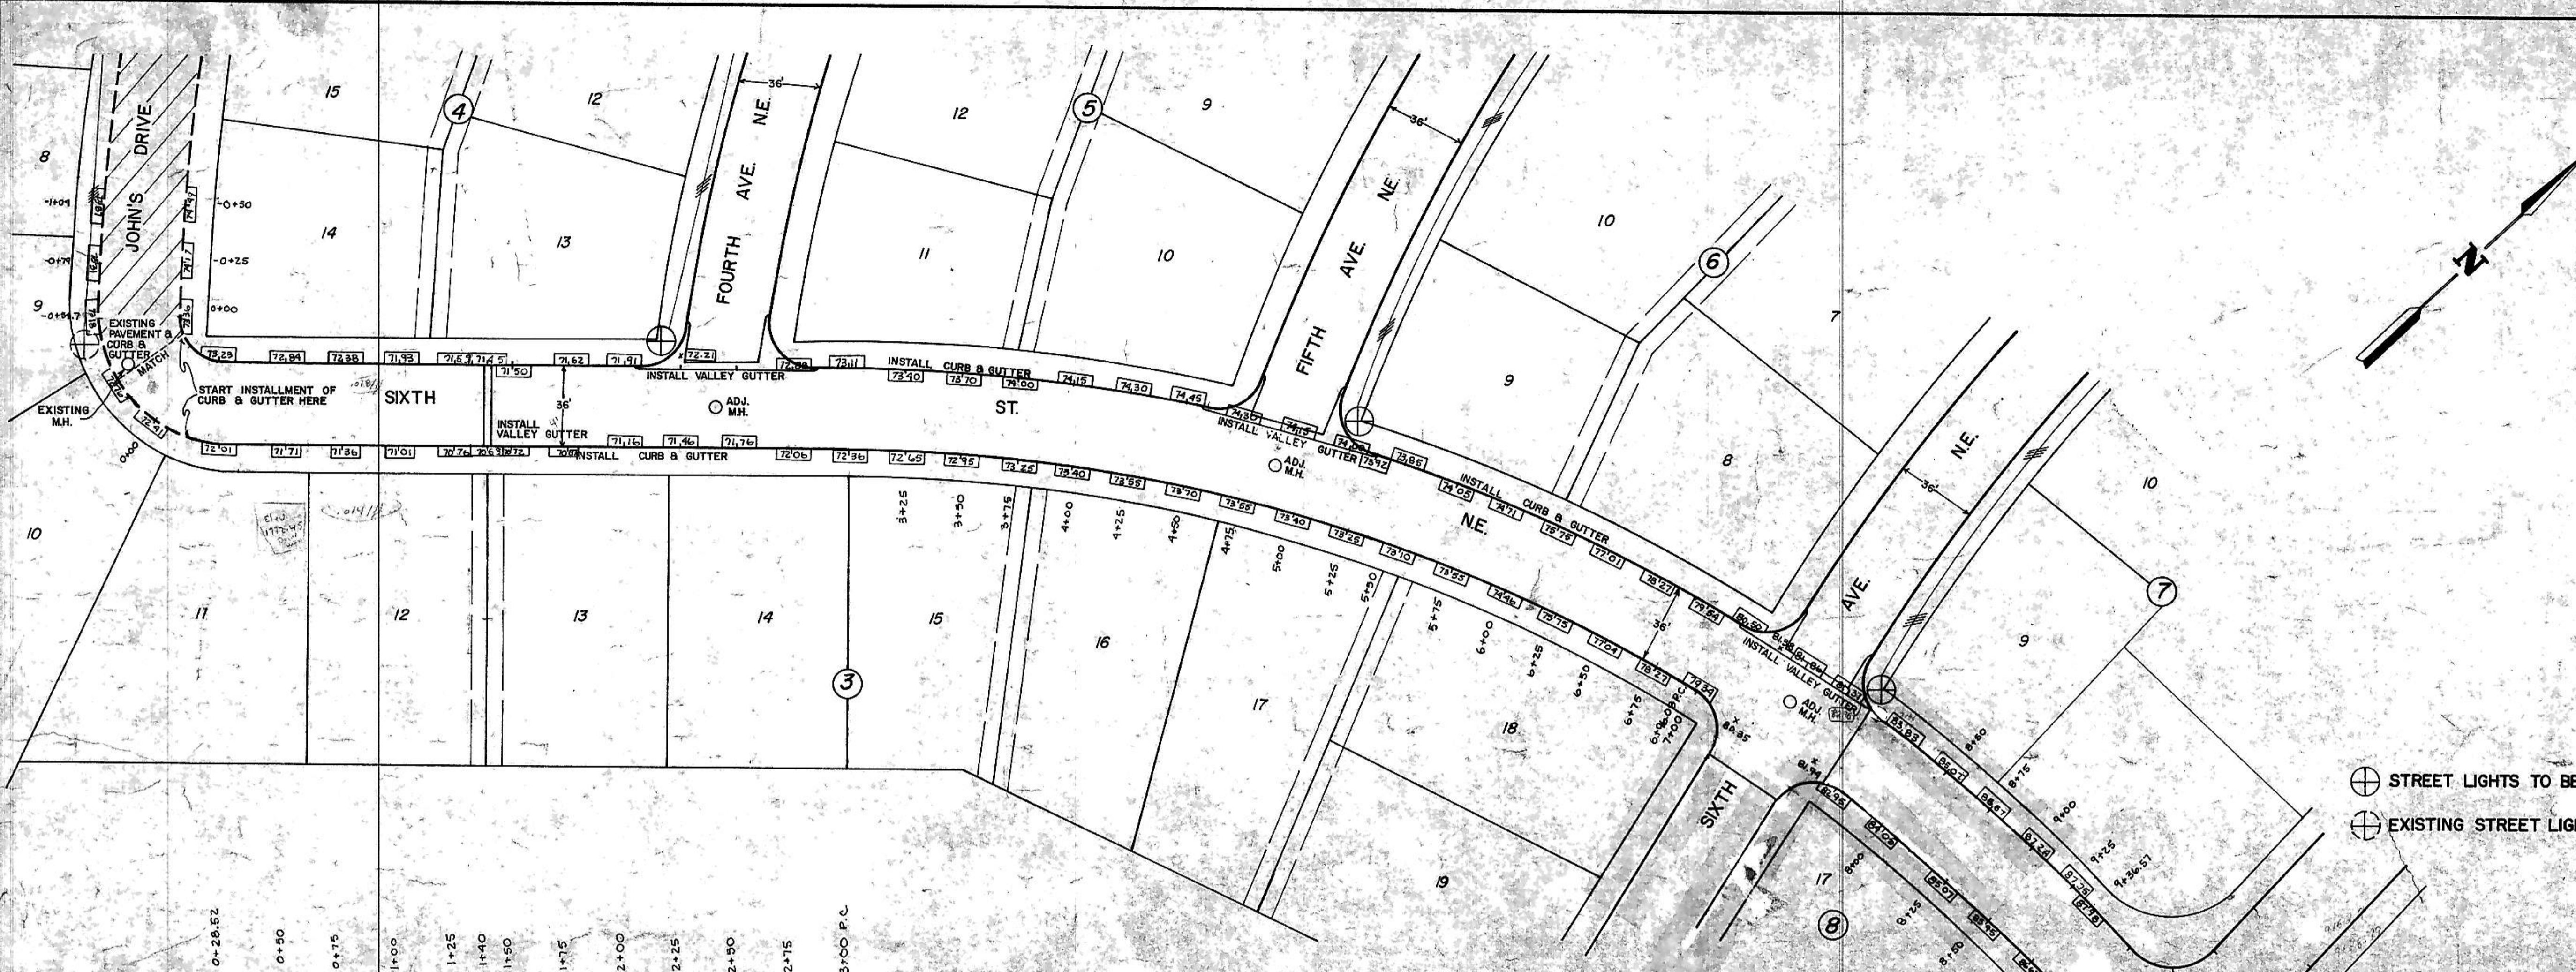

⊕ STREET LIGHTS TO BE INSTALLED
 ⊙ EXISTING STREET LIGHTS

PROFILE
 SURVEYED BY: [blank]
 DATE: [blank]
 NOTE BOOK NO.: [blank]
 GRADES CHECKED BY: [blank]
 STRUCTURE NOTATIONS CHECKED BY: [blank]

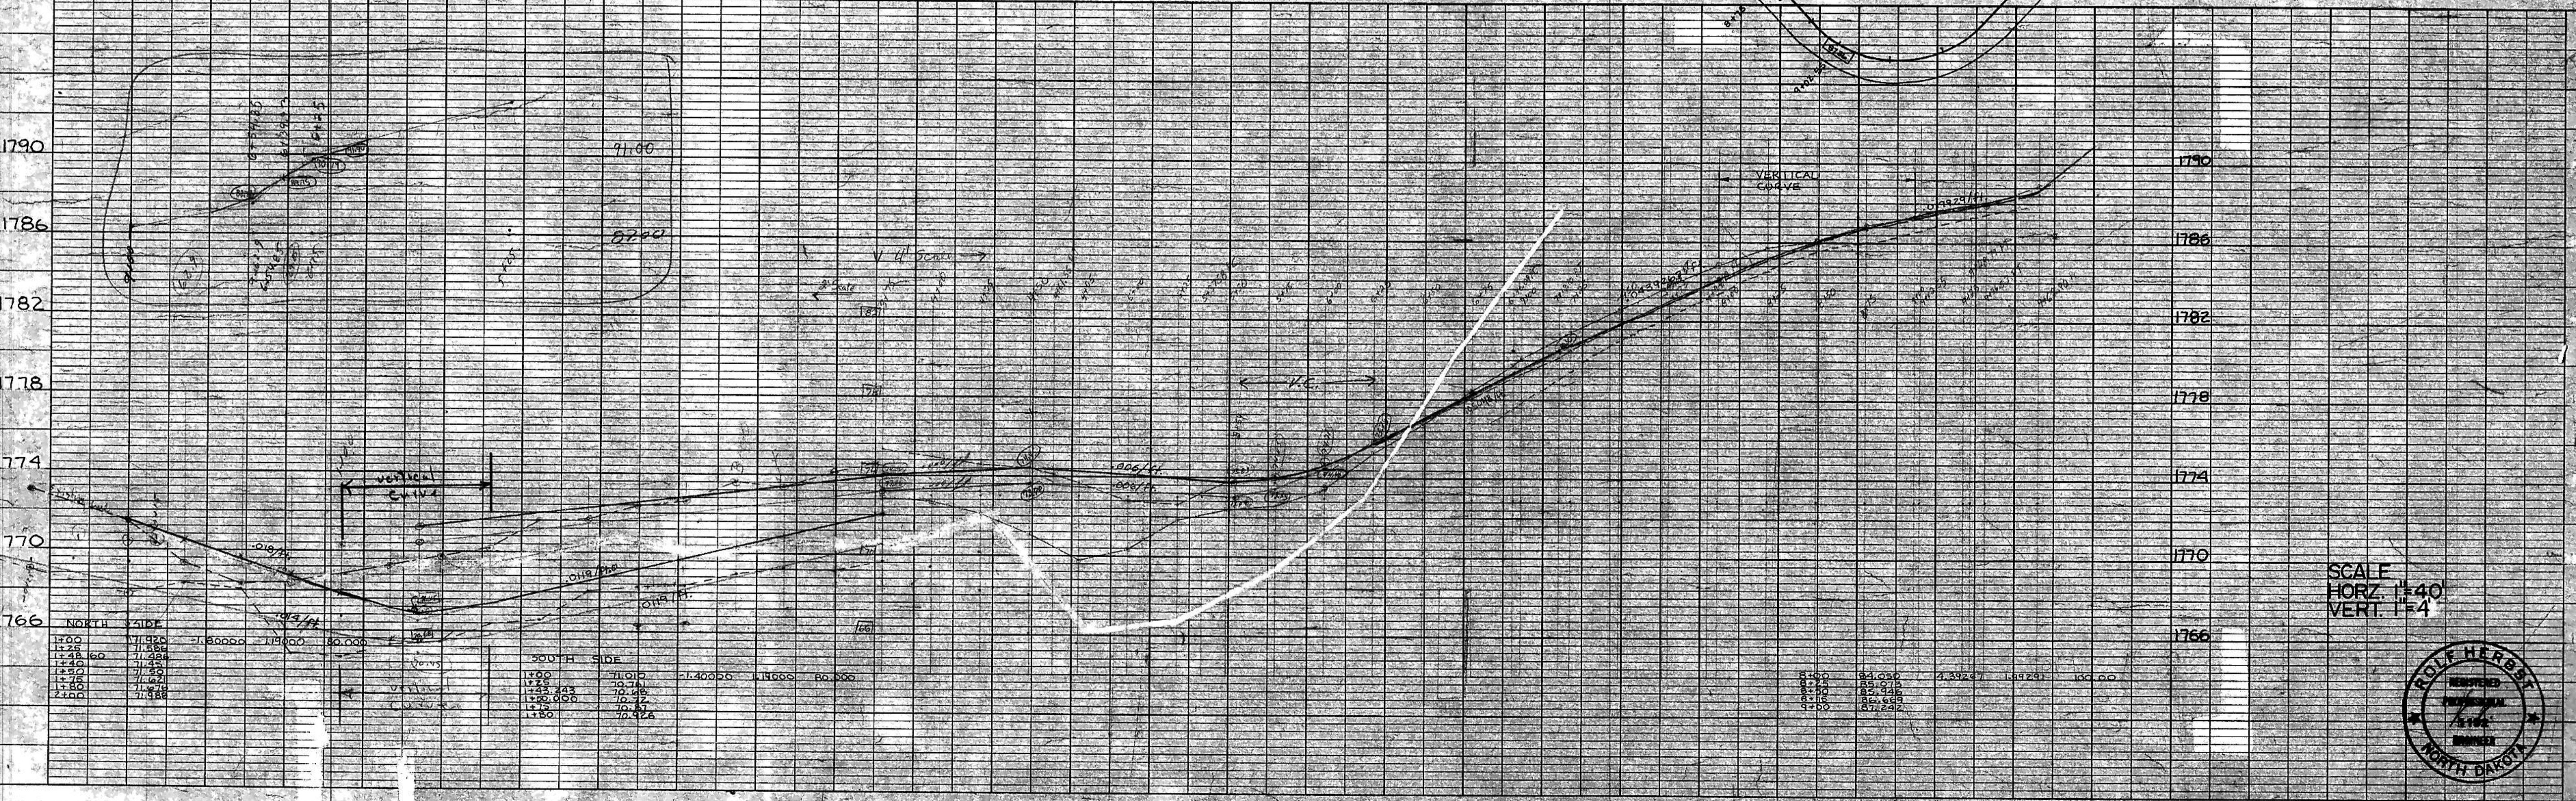

STATION	NORTH SIDE	SOUTH SIDE

8+25	85.148			
8+50	86.246			
8+75	86.688			
9+00	87.250			

SCALE
 HORZ. 1"=40'
 VERT. 1"=4'

