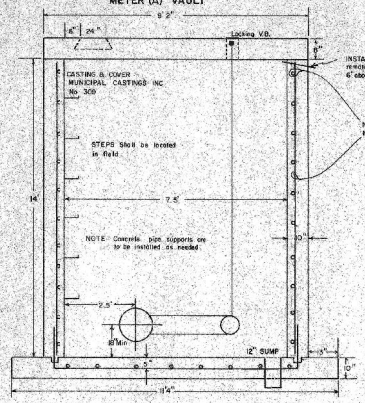

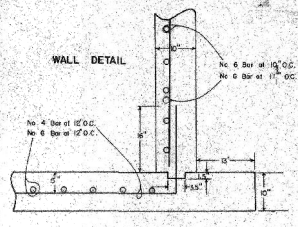

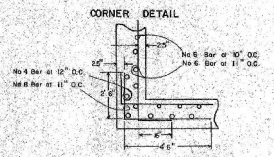

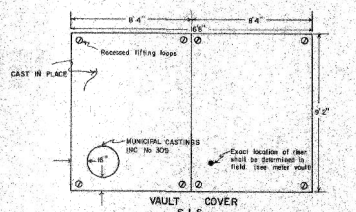

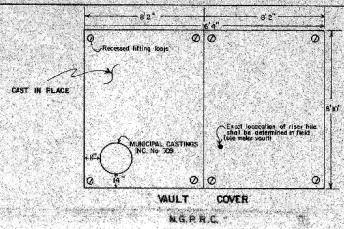

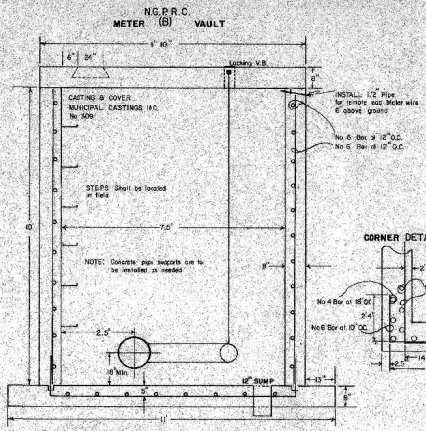

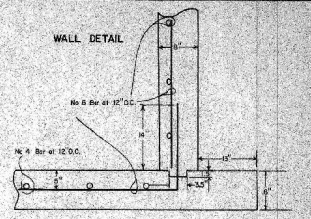

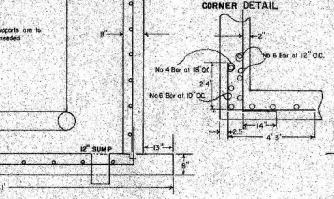

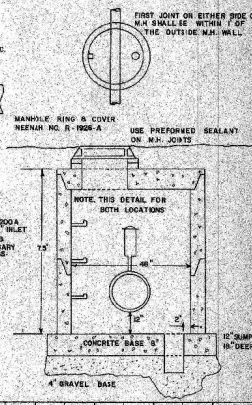

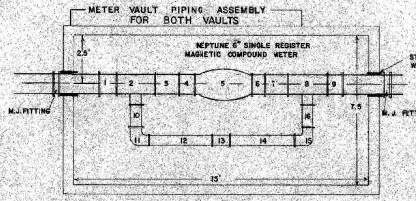

NOTE: ALL JOINTS IN METER VAULT ARE TO BE FLANGED & BOLT CONNECTIONS

METER VAULT & PIPE ASSEMBLY DIMENSIONS AT N.S

1-12" SPOOL - 52" L	9- 12" SPOOL 12" L
2-12 x 6" TEE - 24" L	10- 6" SPOOL 15 1/4" L
3-12" G.V. - 14" L	11- 90° BEND 7" R
4- 12 x 6" REDUCER 14" L	12- 6" SPOOL 37 1/4" L
5-6" COMPOUND METER 24" L	13- 6" G.V. 8 1/2" L With Riser
6-12 x 6" PRODUCER 14" L	14- 6" SPOOL 30 1/4" L
7- 12" G.V. - 14" L	15- 90° BEND 7" R
8- 12" x 6" TEE - 24" L	16- 6" SPOOL 15 1/4" L

METER VAULT & PIPE ASSEMBLY DIMENSIONS AT N.G.P.R.C.

1-6" SPOOL - 12" L	8- 6" SPOOL - 12" L
2- 6" x 6" TEE - 18" L	9- 6" SPOOL - 19" L
3- 6" G.V. - 10 1/2" L	10- 90° BEND 7" R
4- 6" SPOOL - 12" L	11- 6" SPOOL 29 1/4" L
5- 6" COMPOUND METER	12- 6" G.V. 8 1/2" L With Riser
6- 6" SPOOL - 12" L	13- 6" SPOOL 23 1/4
7- 6" G.V. - 10 1/2" L	14- 90° BEND 7" R
8- 6" x 6" TEE - 18" L	15- 6" SPOOL 12" L

AS BUILT

PROJECT 85-2

SHEET 10 OF 10