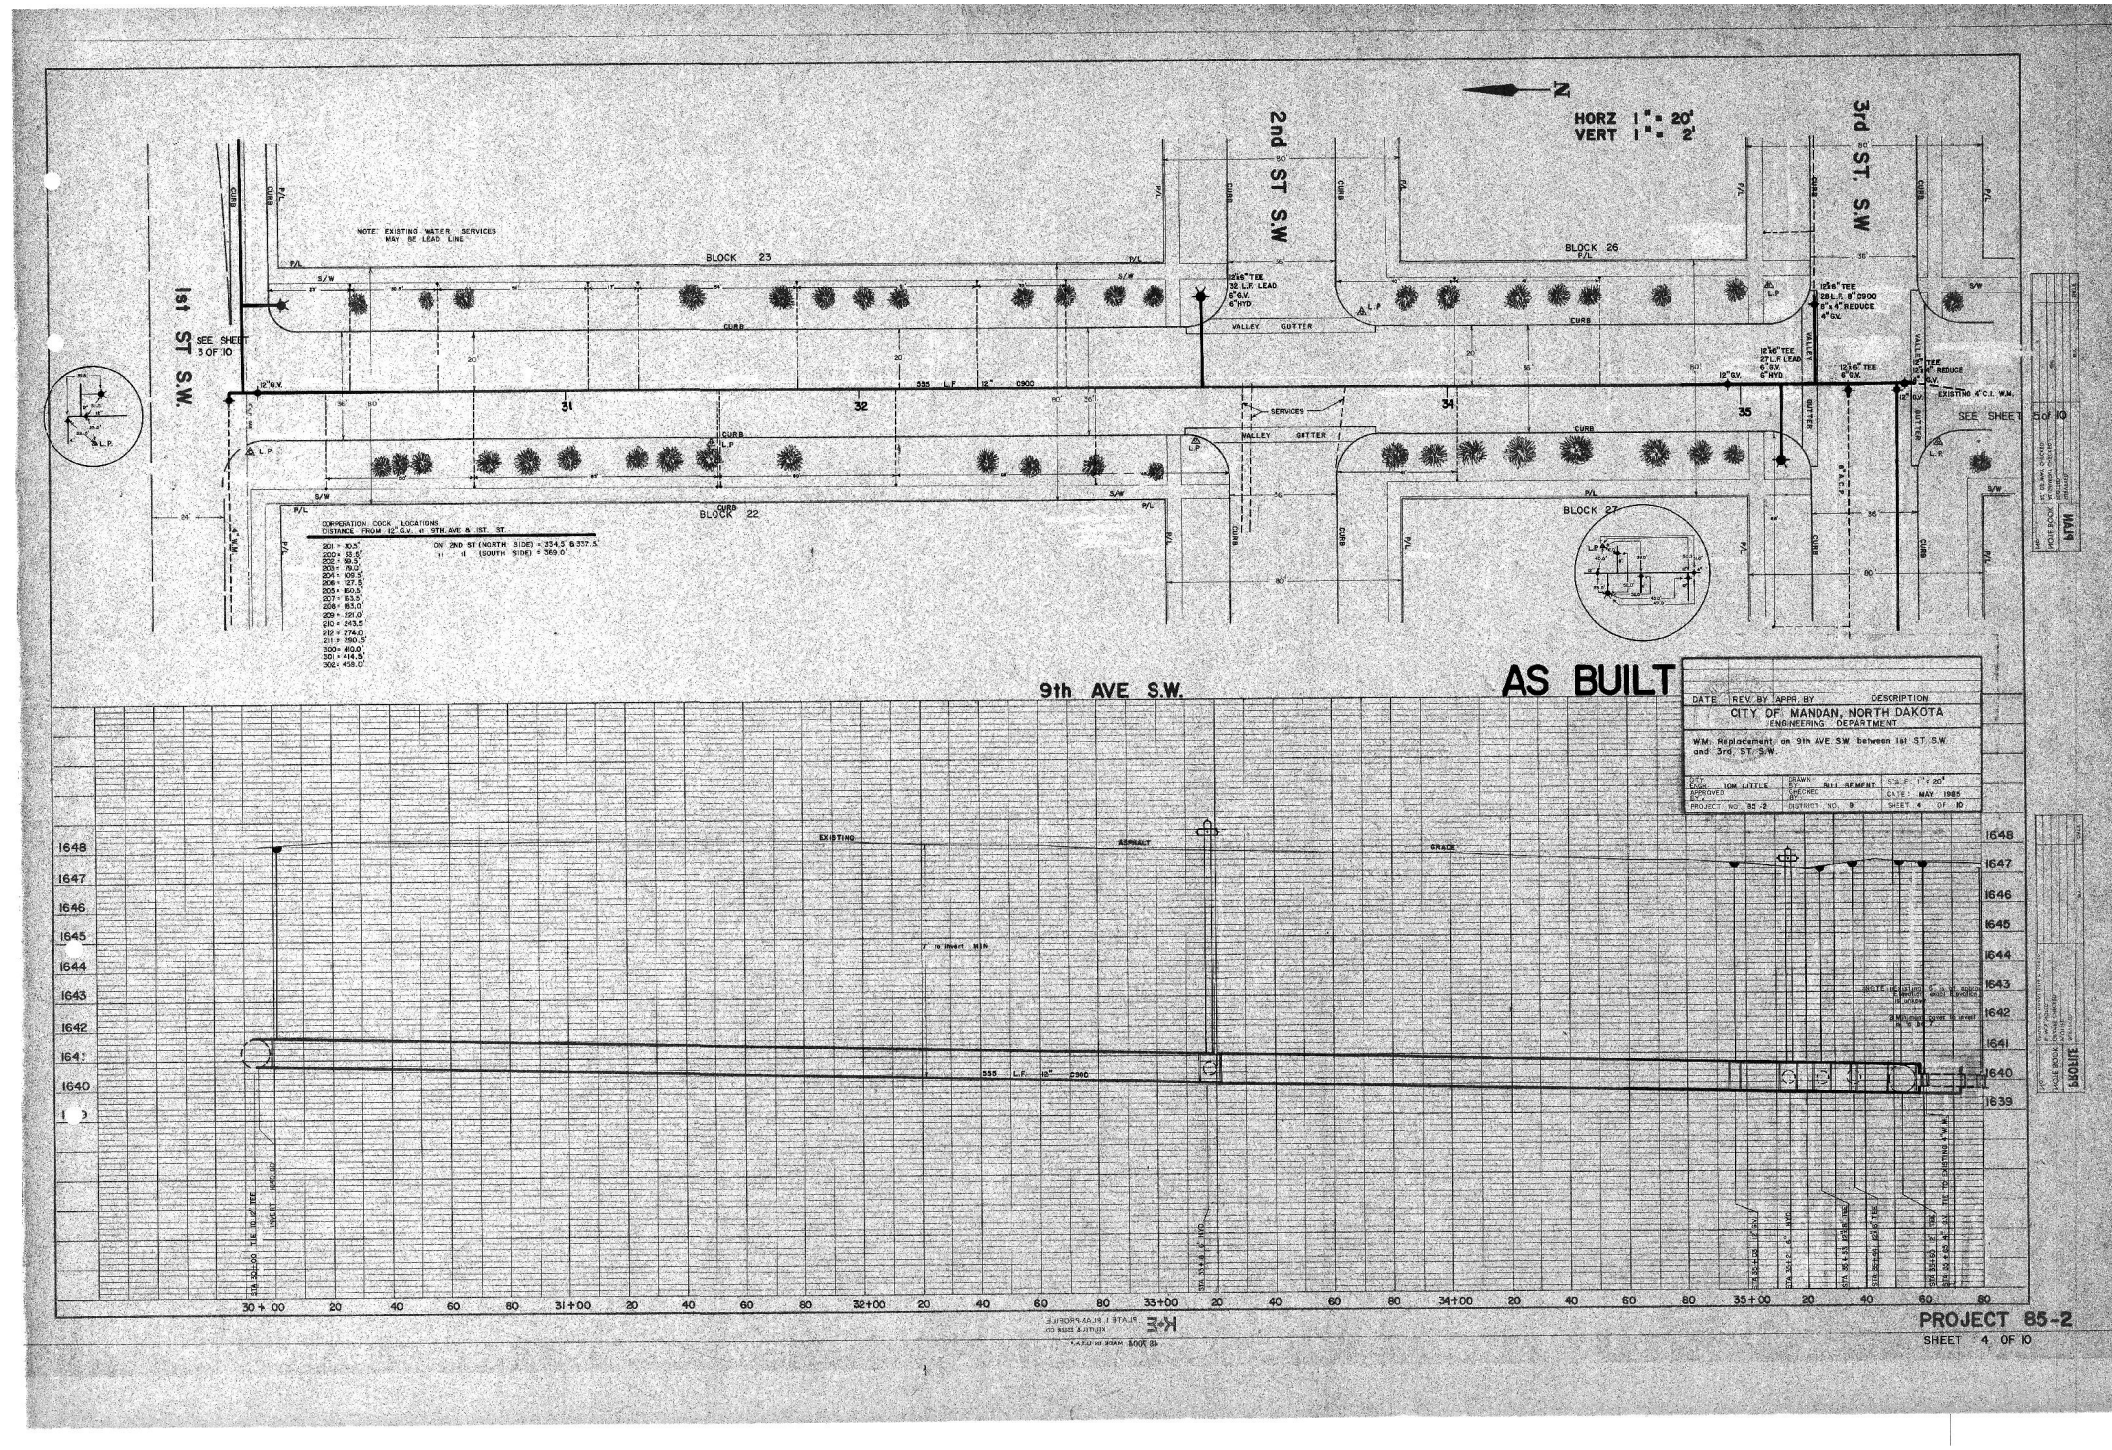
HORZ 1" = 20'
VERT 1" = 2'
N
1st ST S.W.
2nd ST S.W
3rd ST. S.W
9th AVE S.W.
AS BUILT
BLOCK 23
BLOCK 26
BLOCK 22
BLOCK 27
NOTE: EXISTING WATER SERVICES MAY BE LEAD LINE
SEE SHEET 3 OF 10
SEE SHEET 5 OF 10
CORPORATION COCK LOCATIONS
DISTANCE FROM 12" G.V. at 9TH AVE & 1ST. ST.
201 = 30.5'
202 = 93.5'
203 = 79.0'
204 = 109.5'
206 = 127.5'
207 = 63.5'
208 = 85.0'
209 = 191.0'
210 = 243.5'
212 = 274.0'
211 = 150.5'
300 = 40.0'
301 = 414.5'
302 = 458.0'
ON 2ND ST (NORTH SIDE) = 354.5 & 357.5'
" " (SOUTH SIDE) = 369.0'
DATE REV. BY APPR. BY DESCRIPTION
CITY OF MANDAN, NORTH DAKOTA
ENGINEERING DEPARTMENT
W.M. Replacement on 9th AVE. SW between 1st ST. S.W. and 3rd. ST. S.W.
DESIGN TOM LITTLE
DRAWN SILVEMENT
CHECKED
APPROVED
DATE MAY 1985
PROJECT NO. 85-2
DISTRICT NO. 8
SHEET 4 OF 10
EXISTING
ASPHALT
GRADE
555 L.F. 12" C900
30+00
31+00
32+00
35+00
34+00
1648
1647
1646
1645
1644
1643
1642
1641
1640
1639
PROJECT 85-2
SHEET 4 OF 10