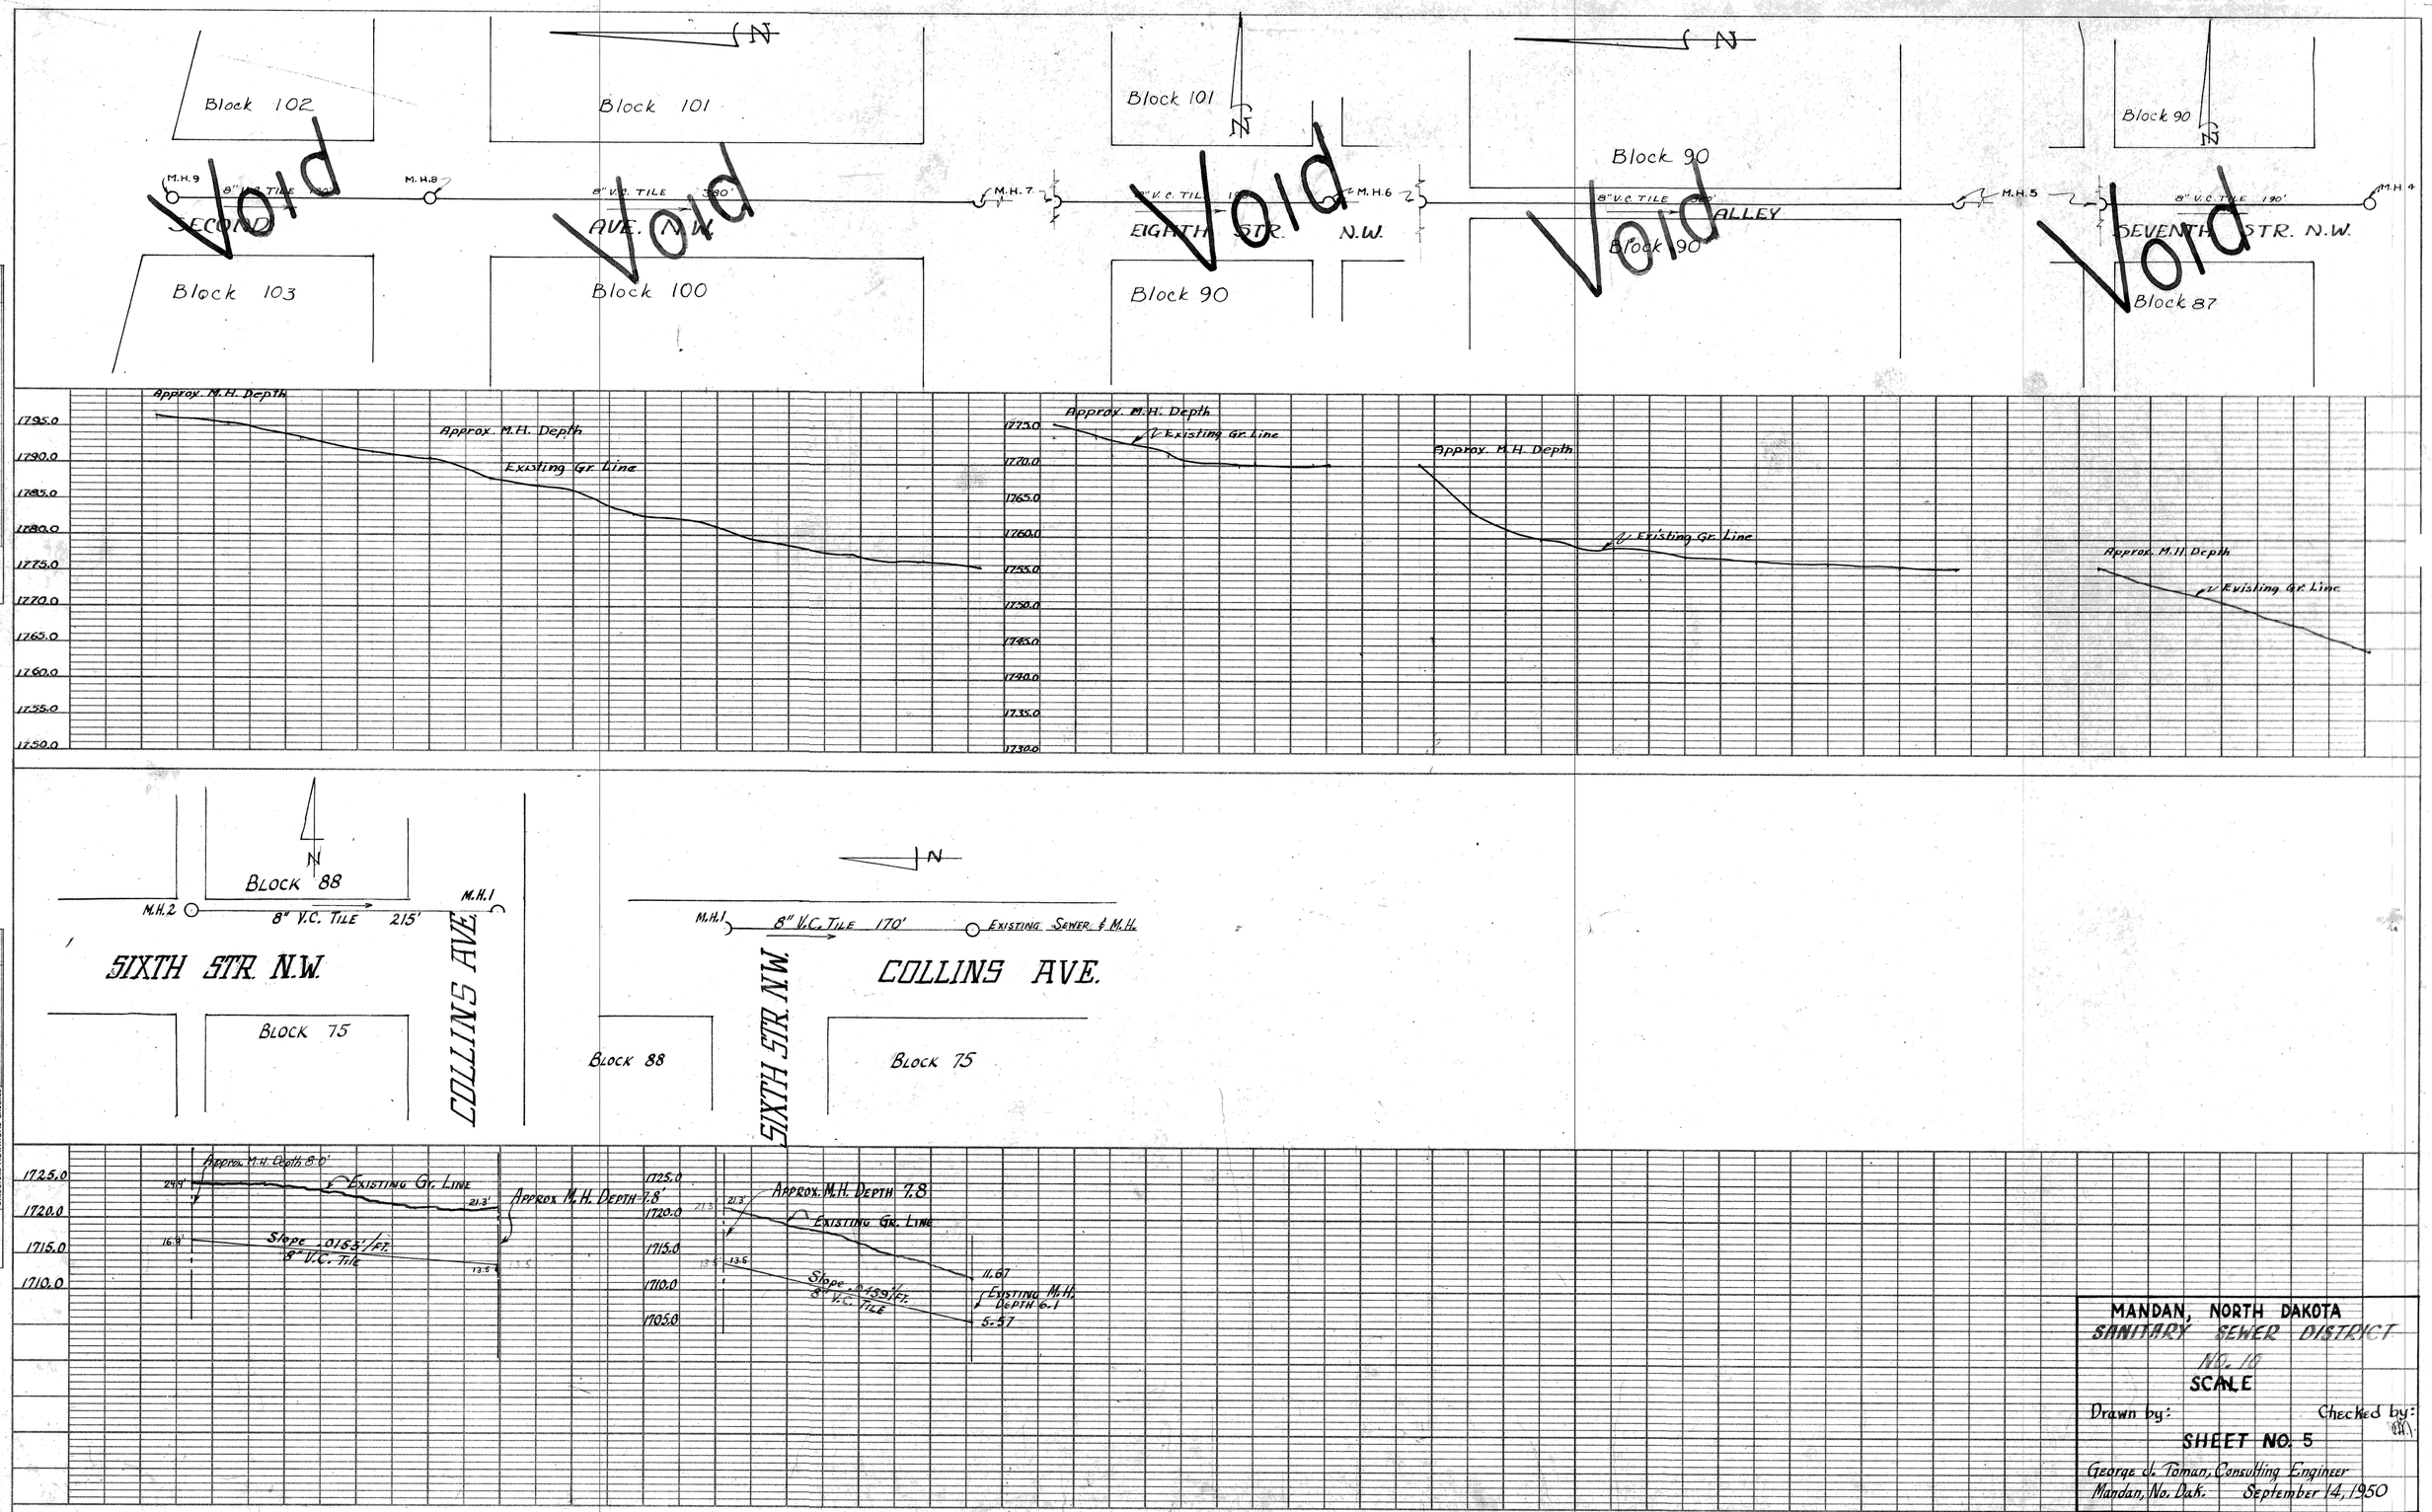

MANDAN, NORTH DAKOTA
SANITARY SEWER DISTRICT
NO. 10
SCALE
Drawn by: Checked by:
SHEET NO. 5
George J. Toman, Consulting Engineer
Mandan, No. Dak. September 14, 1950

PLATE 2—PLAN-PROFILE O. P. R. & R. E. STANDARD
THE FREDERICK POST CO., CHICAGO