
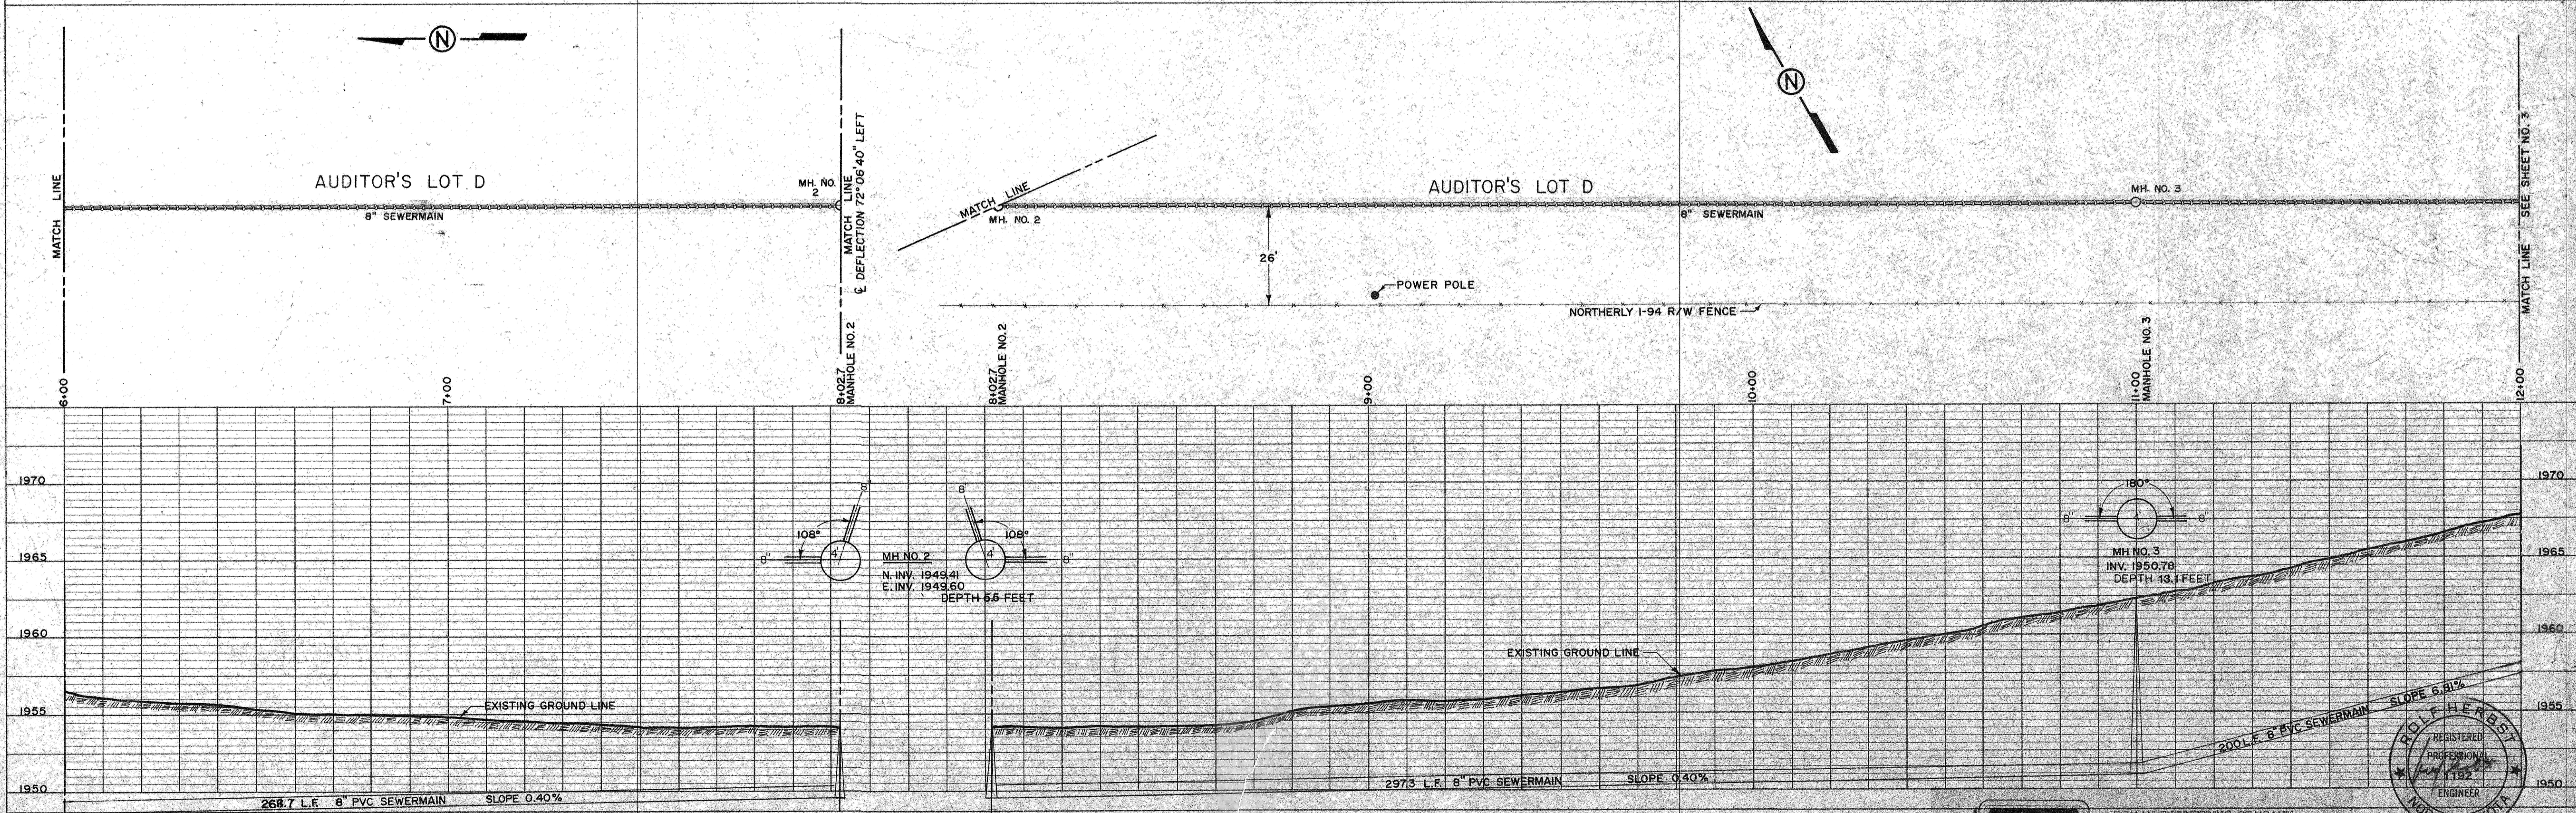
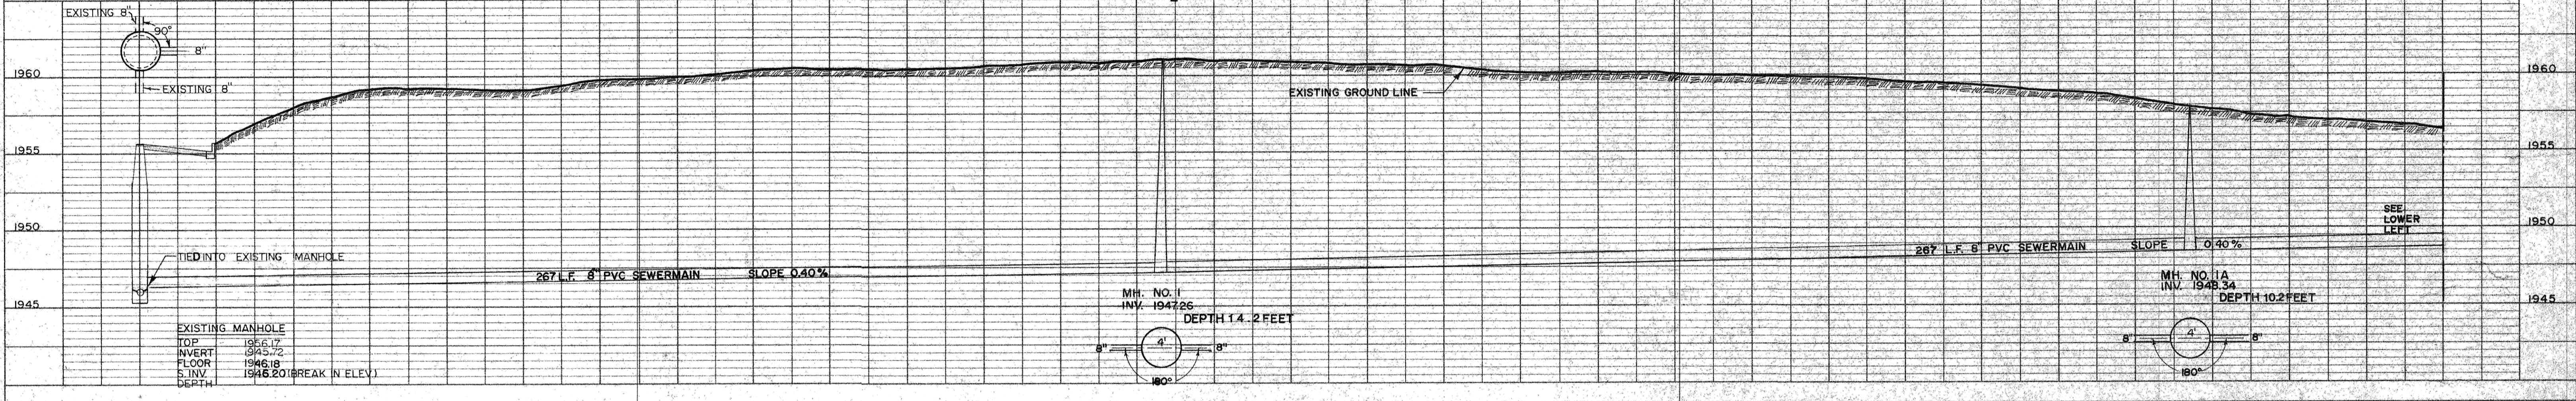


NOTE BOOK ALIGNMENT CHECKED
 No. _____


NOTE BOOK GRADE CHECKER
 No. _____

NOTE BOOK SPECIFICATIONS CHECKER
 No. _____

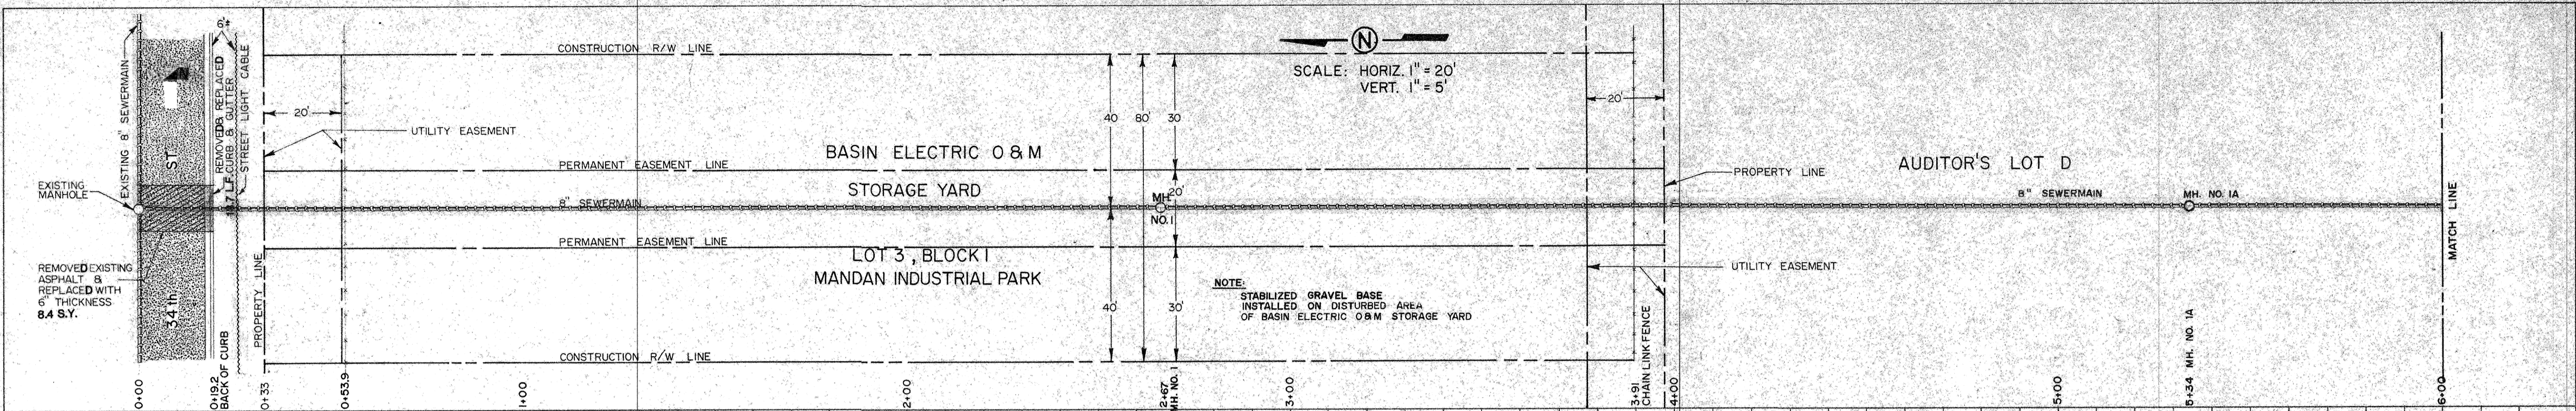


ROADWAY FEDERAL 818 SHEET
 PLATE 2-DOUBLE PLAN AND PROFILE-FULL LINE
 7 1/2" TELETYPE
 PRINTED IN U.S.A.

REVISED 1982

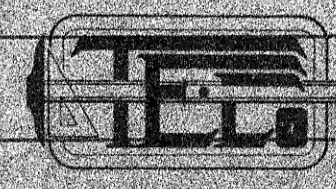

YOMAN ENGINEERING COMPANY
 CONSULTING ENGINEERS & SURVEYORS
 P.O. BOX 706 • 609 2ND ST. N.W.
 MANDAN, NORTH DAKOTA 58544 • 701-833-8555
 TECO NO. 3157

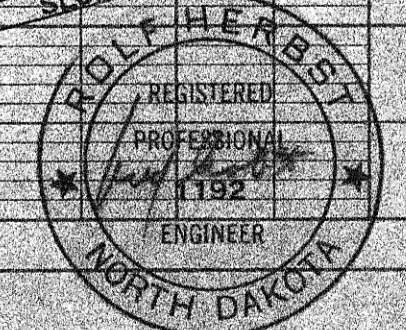

SHEET NO. 2 OF 5 SHEETS
ASBUILT DRAWING